


HANNEY & ASSOCIATES, ARCHITECTS
 1726 South Hillside, Wichita, Kansas, 67211
 Phone (316) 683-8985
 Fax (316) 684-1441

2022
GENESIS HEALTH CLUBS
 SOUTHBRIDGE MALLSPACE 0010
 1111 East Army Post Road
 Des Moines, Iowa 50315

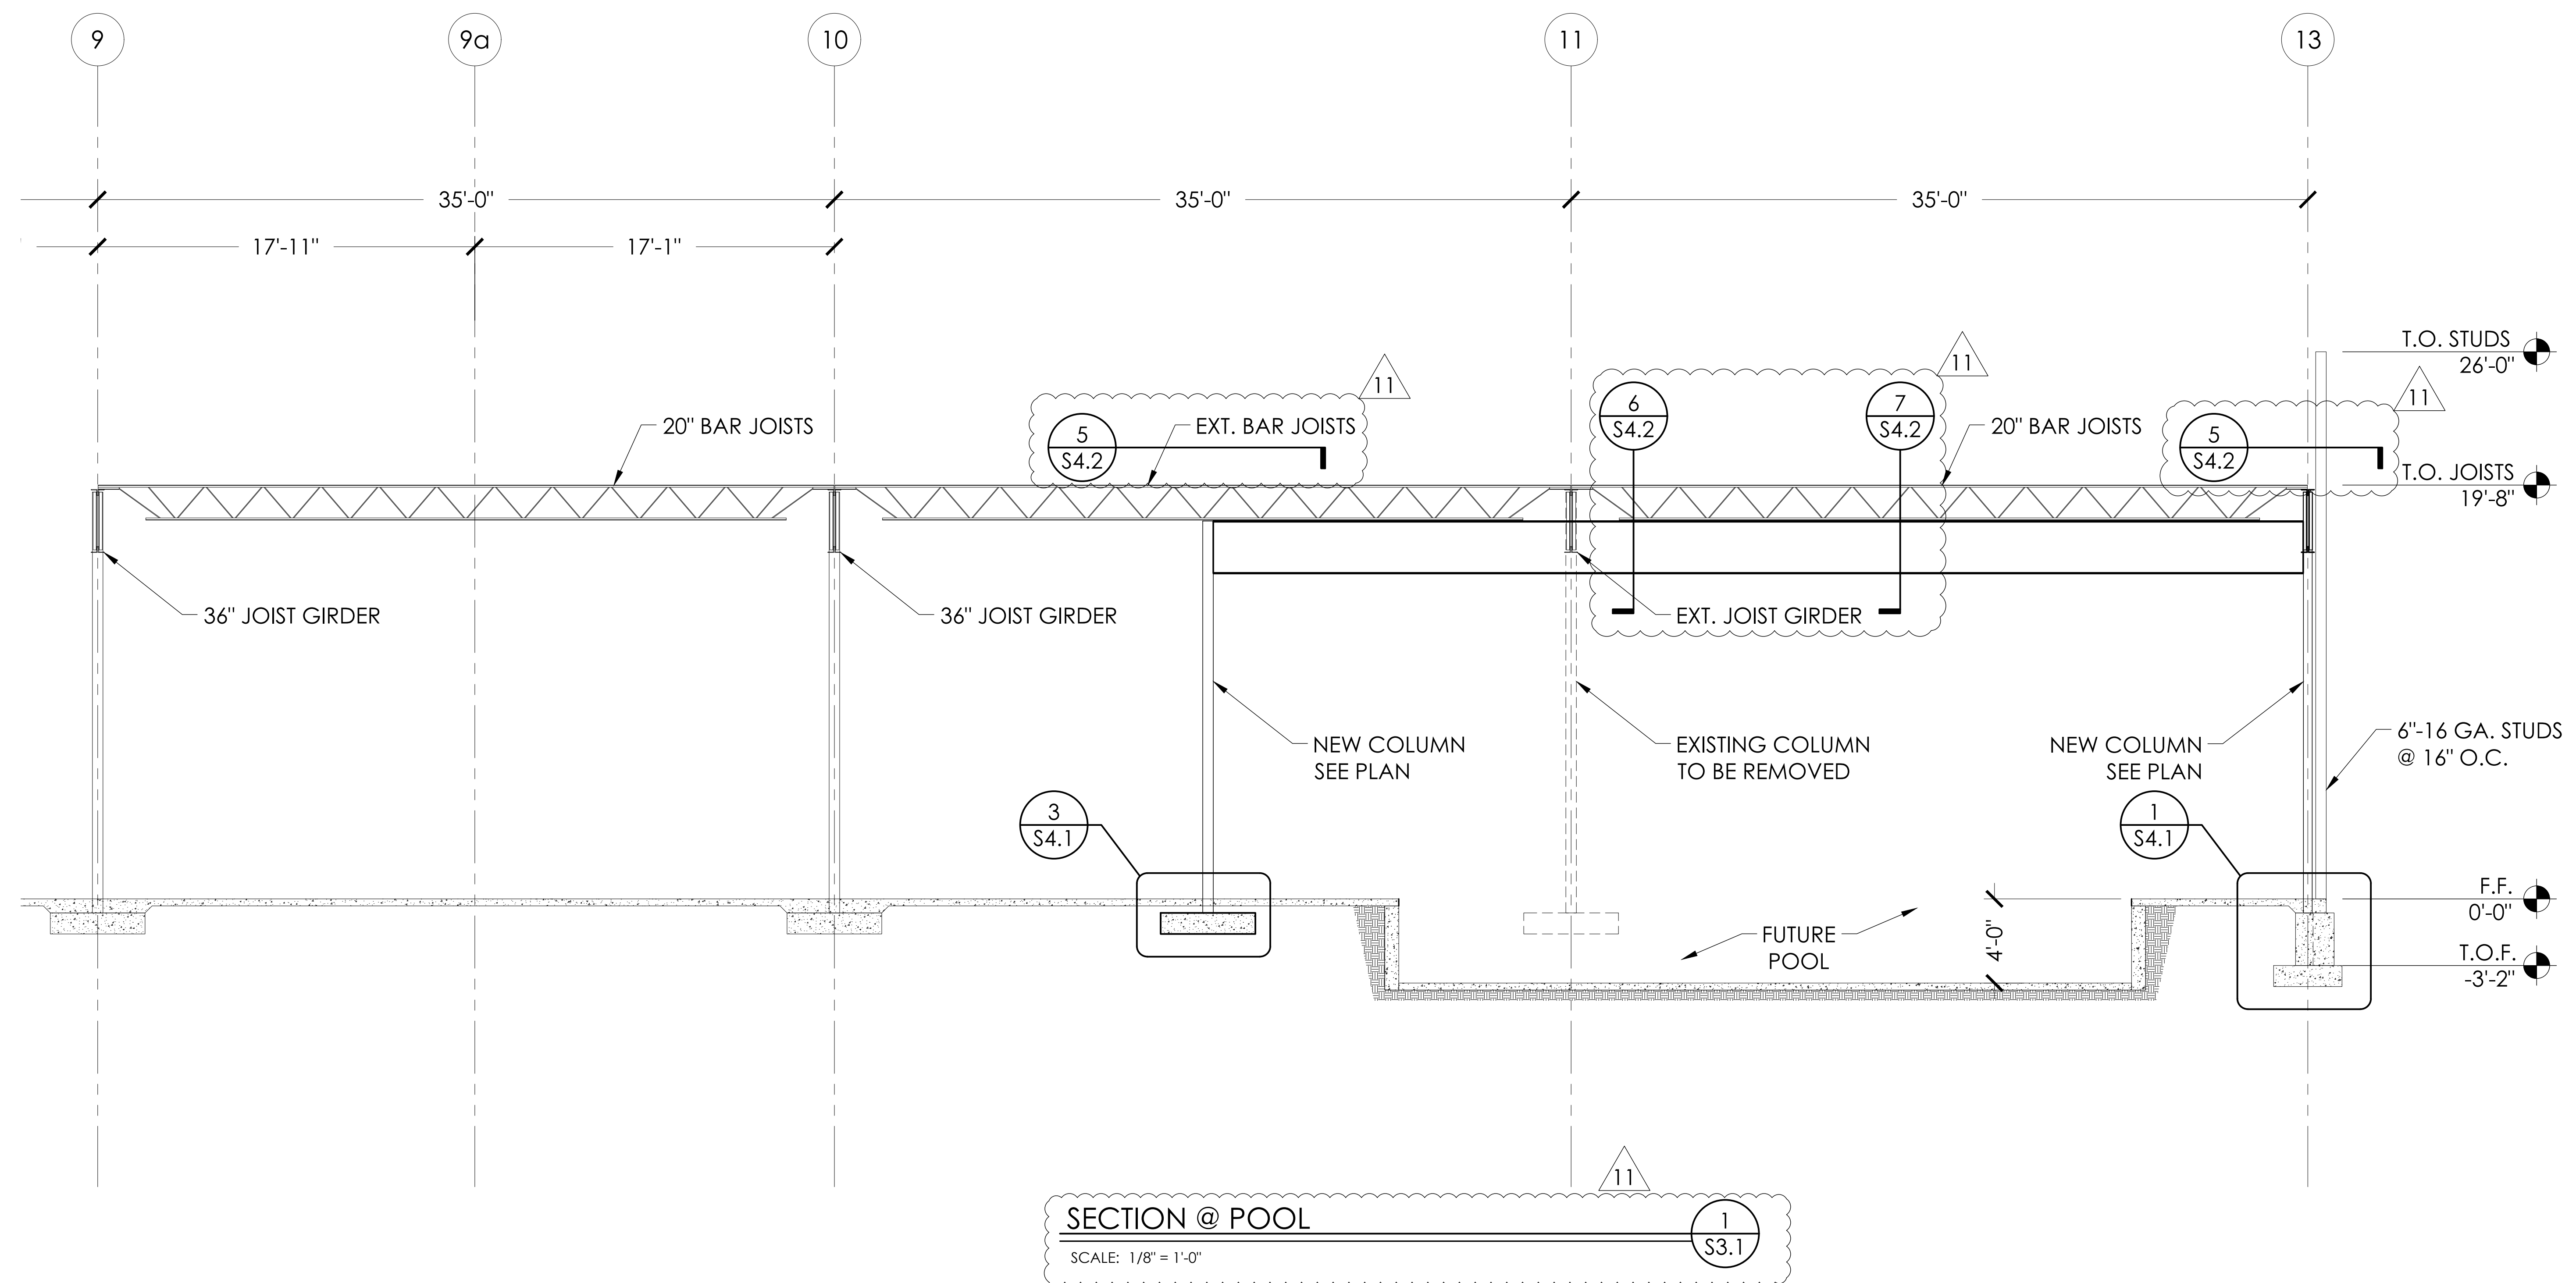

DRAWINGS ISSUED			
NO.	DATE	ITEM	ISSUED
11	5/6/22	ADDENDUM #4	
10	3/25/22	CODE REVISIONS	
9	3/1/22	PERMIT SET	
8	1/25/22	CHECK SET	
7	12/15/21	CHECK SET	
6	9/24/21	CHECK SET	
5	8/27/21	SITE PLAN REVIEW	
4	7/2/21	UDRB SUBMITTAL	
3	7/08/21	MILESTONE DEV. PLAN	
2	5/25/21	CONCEPT. DEV. PLAN	
1	3/20/21	CONCEPT. DEV. PLAN	

COMPUTER DRAWING
 U21-062

DATE: 5/6/2022
 DRAWN BY: WDM CHECKED BY: CJS

SHEET
S3.1

FOR PERMIT