



HANNEY & ASSOCIATES, ARCHITECTS
 1726 South Hillside, Wichita, Kansas, 67211
 Phone (316) 883-8965
 Fax (316) 884-1441
 www.haarchitects.com

2019 BOOT BARN WAREHOUSE EXPANSION

4950 South Laura, Wichita, Kansas 67216

SPACE LEFT INTENTIONALLY BLANK

LEGEND	
SYM	MATERIAL DESCRIPTION
	GRAB BARS, VARIED LENGTH, BY G.C.
	TOILET PAPER DISPENSER BY OWNER
	AIR FRESHNER
	HAT & COAT HOOK
	GLASS MIRROR S.S. FRAME W/ GLASS MIRROR BY G.C.
	BABY CHANGING STATION
	WALL MOUNTED NAPKIN DISPOSAL BY OWNER
	SEAT COVER DISPENSER
	HAND DRYER
	PAPER TOWEL DISPENSER BY OWNER
	SOAP DISPENSER BY OWNER
	FLOOR DRAIN

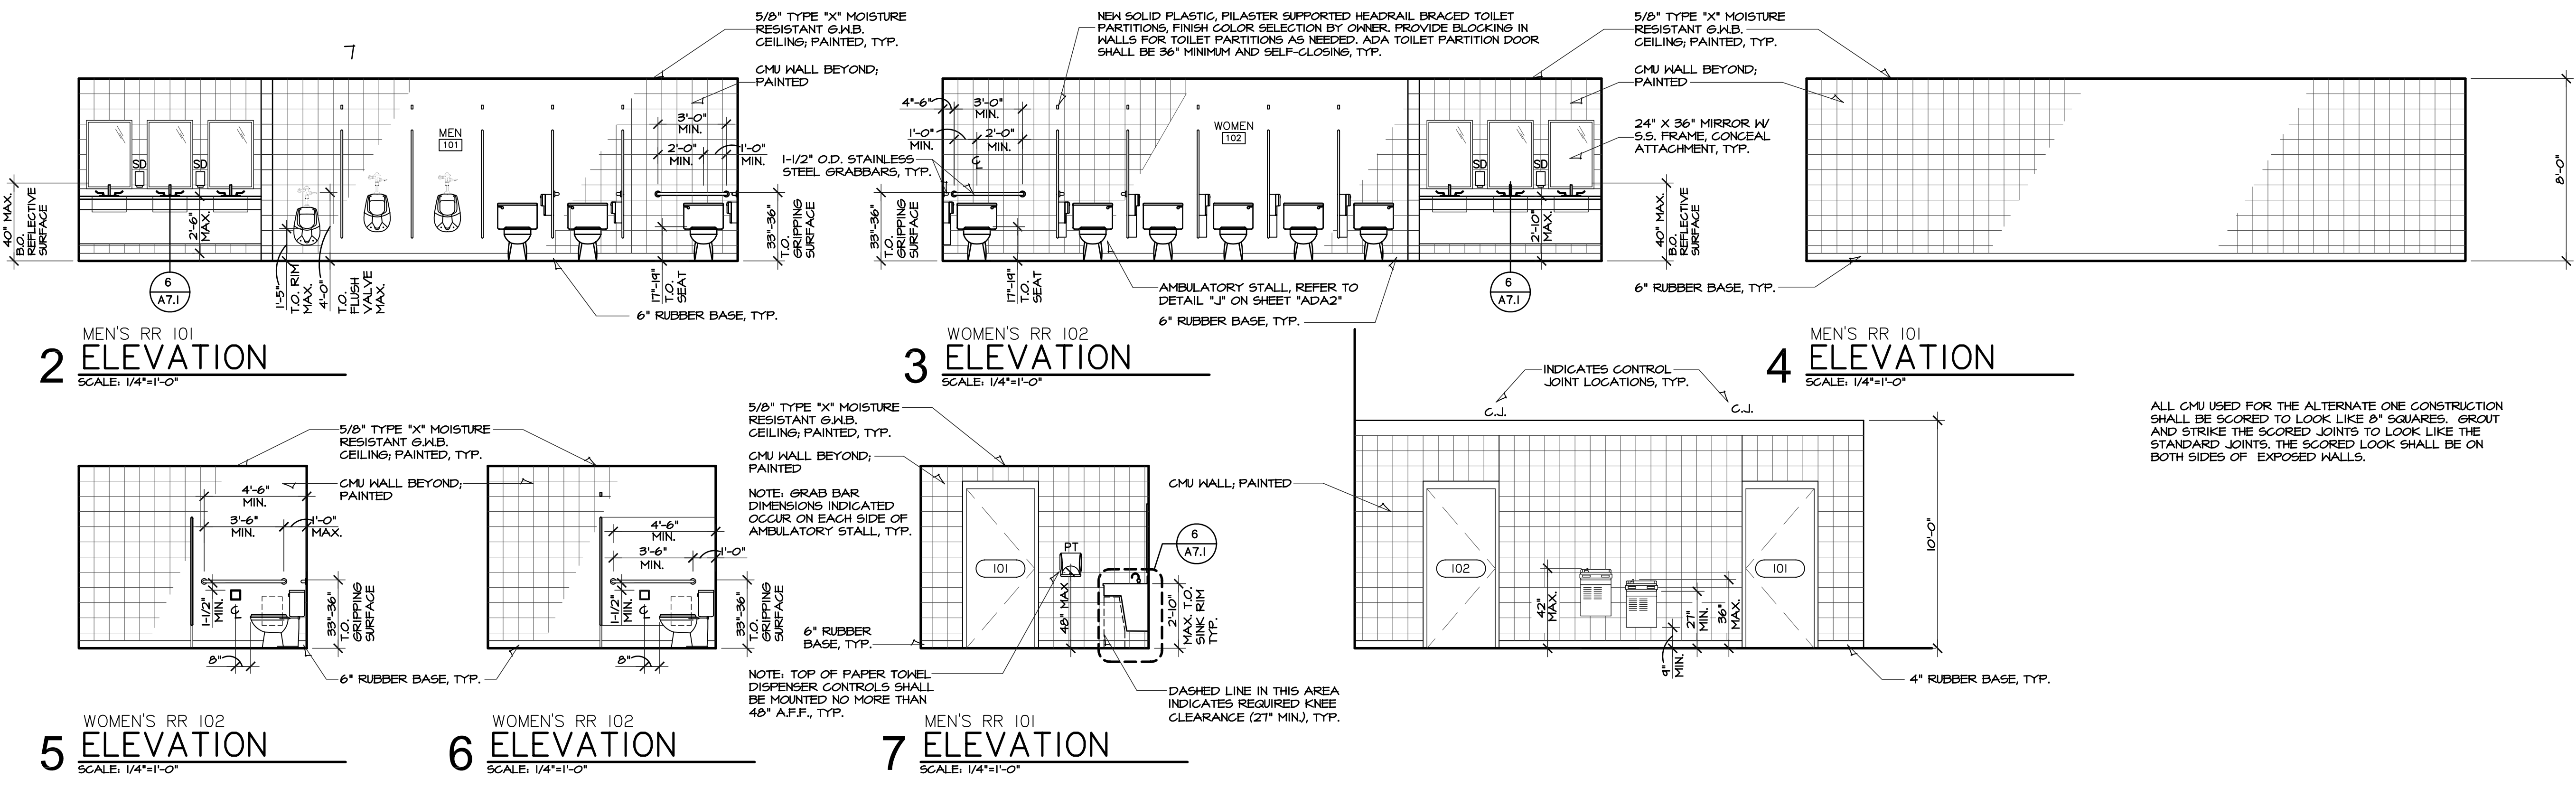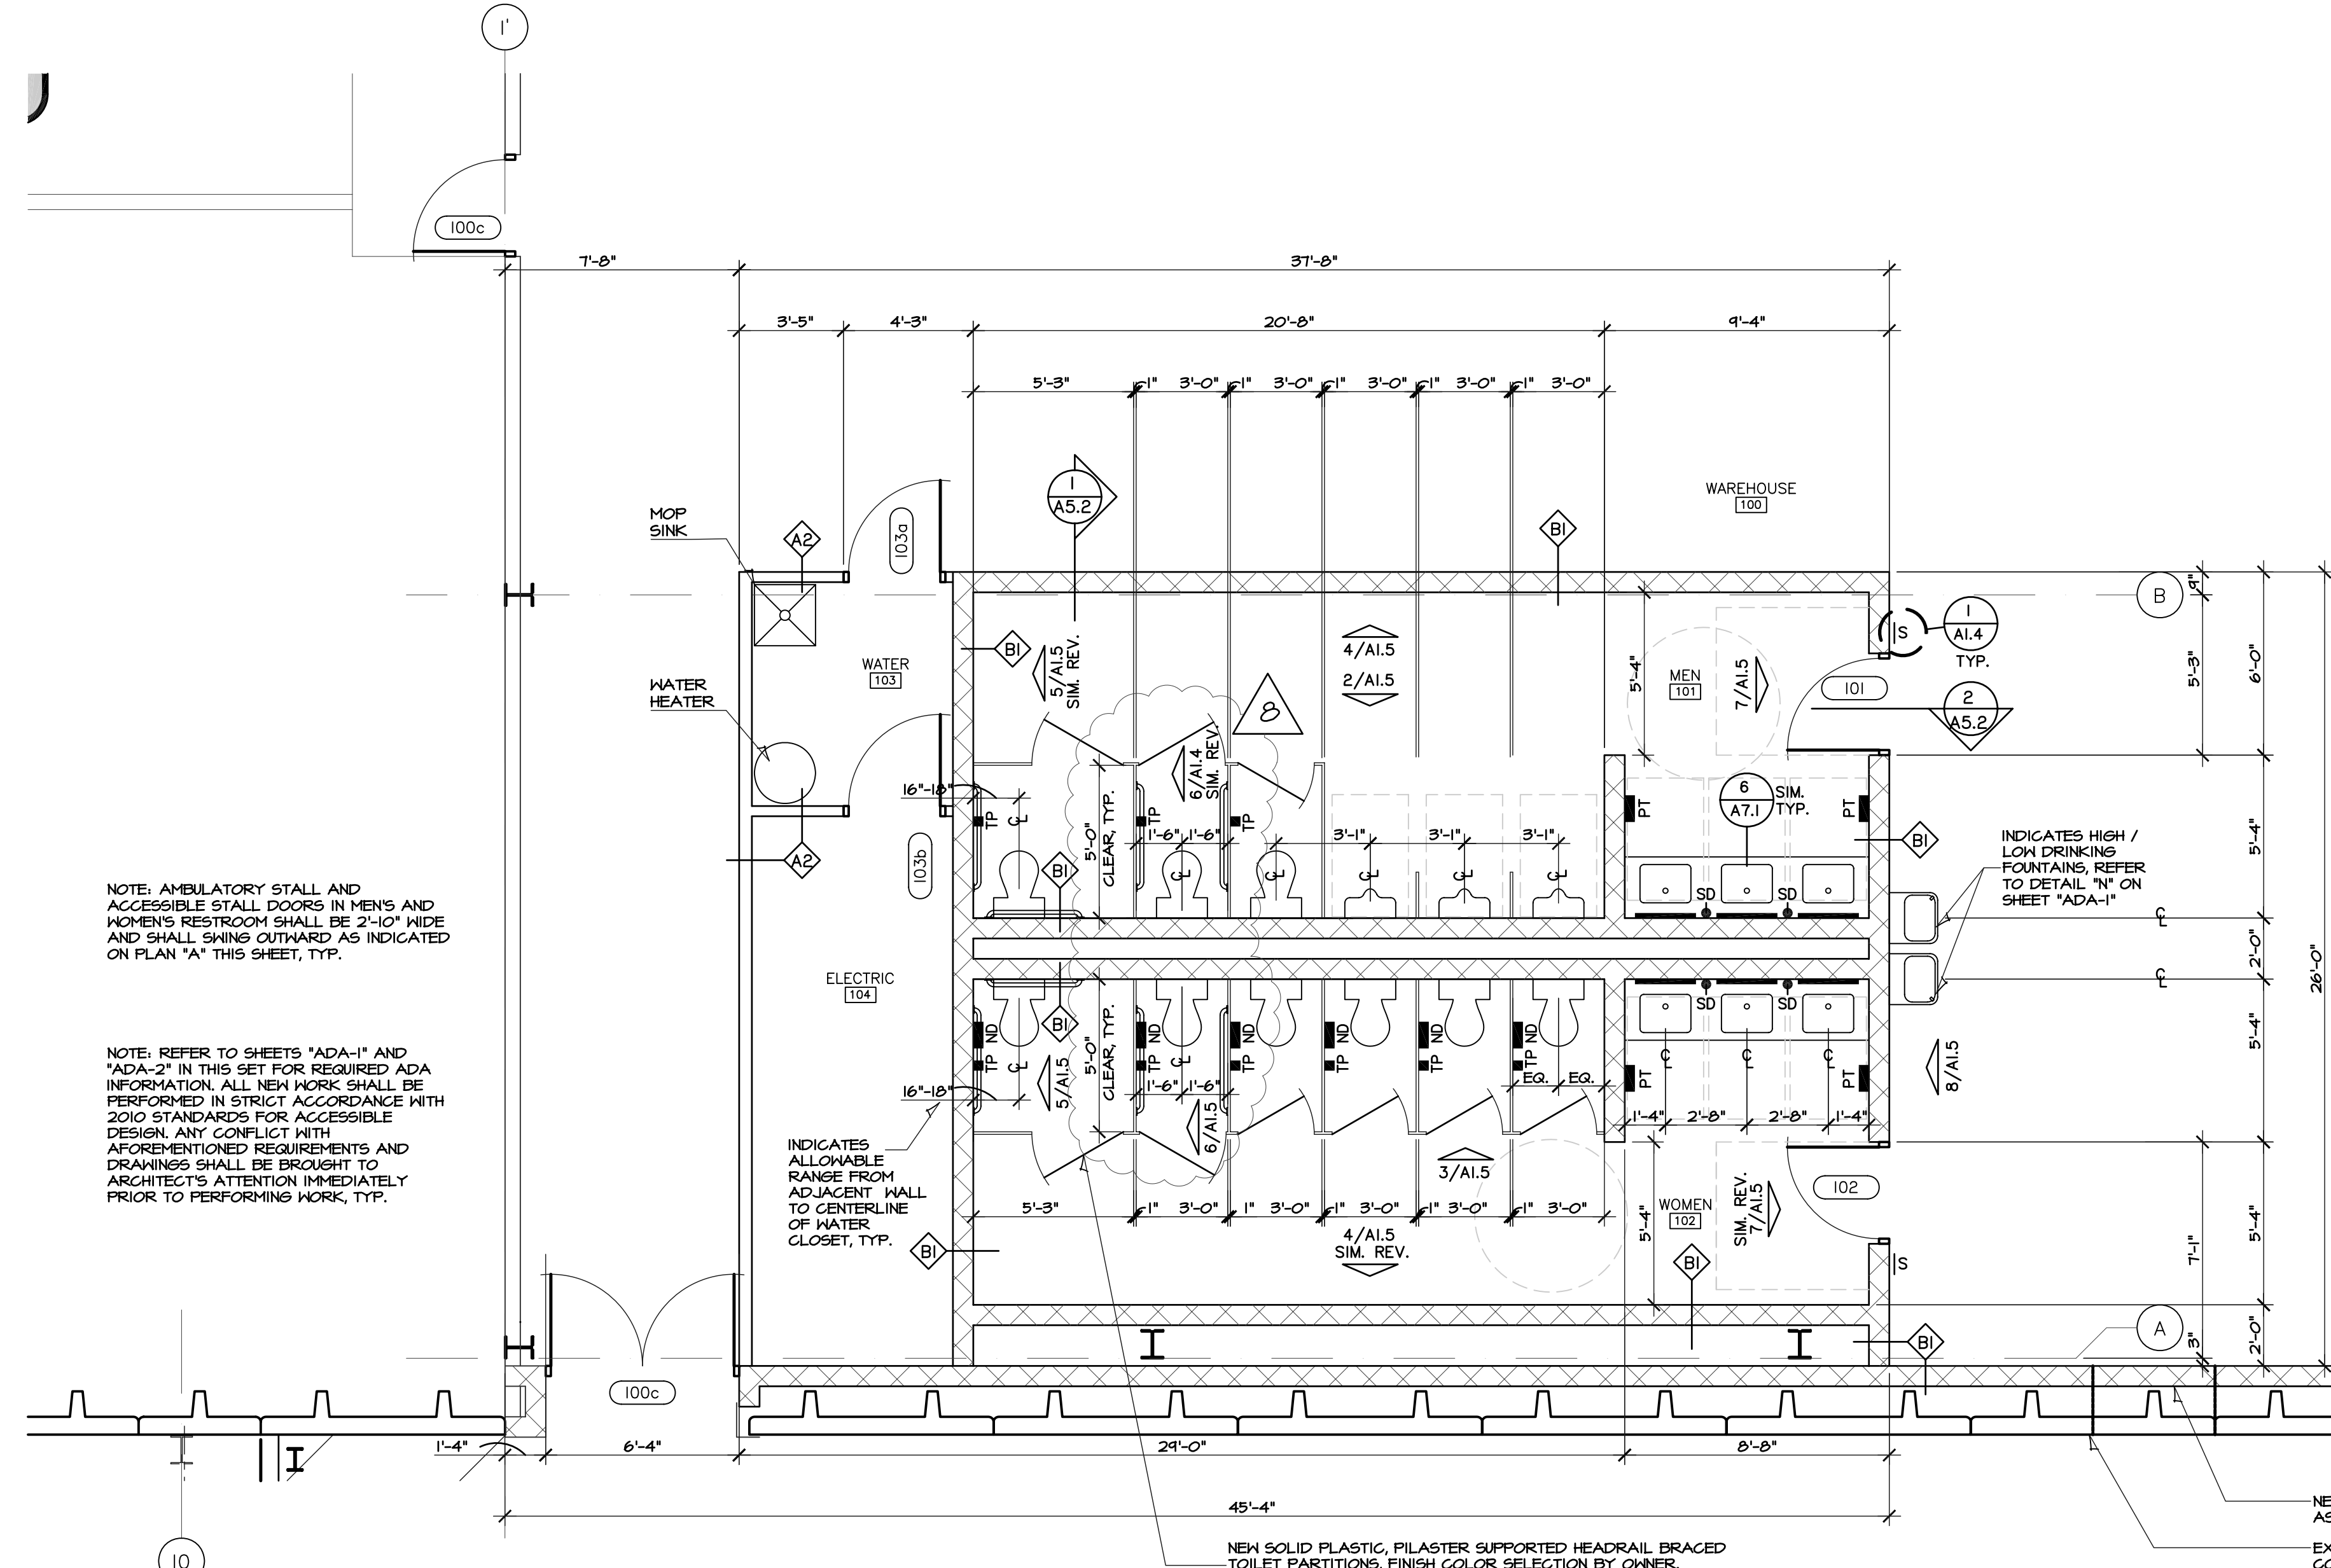

DRAWINGS ISSUED		
NO.	DATE	ITEM ISSUED
7	7/15	PLAN REVIEW REV. 1
6	6/25	100% REVIEW
5	6/14	100% REVIEW
4	6/05	PLAN CHANGE
3	5/28	PLAN CHANGE
2	4/26	REVIEW
1	1/24	REVIEW

COMPUTER DRAWING
 BB_A105.dwg

DATE: JUNE, 2019
 DRAWN BY: MH, BS, CH
 CHECKED BY: MRH

SHEET
A1.5
 OF 1 SHEETS