


**1 EXPANSION JOINT DETAIL**  
SCALE: N.T.S.



**BASE BID  
A FLOOR PLAN**  
SCALE: 1/16" = 1'-0"  
01 5 10 20

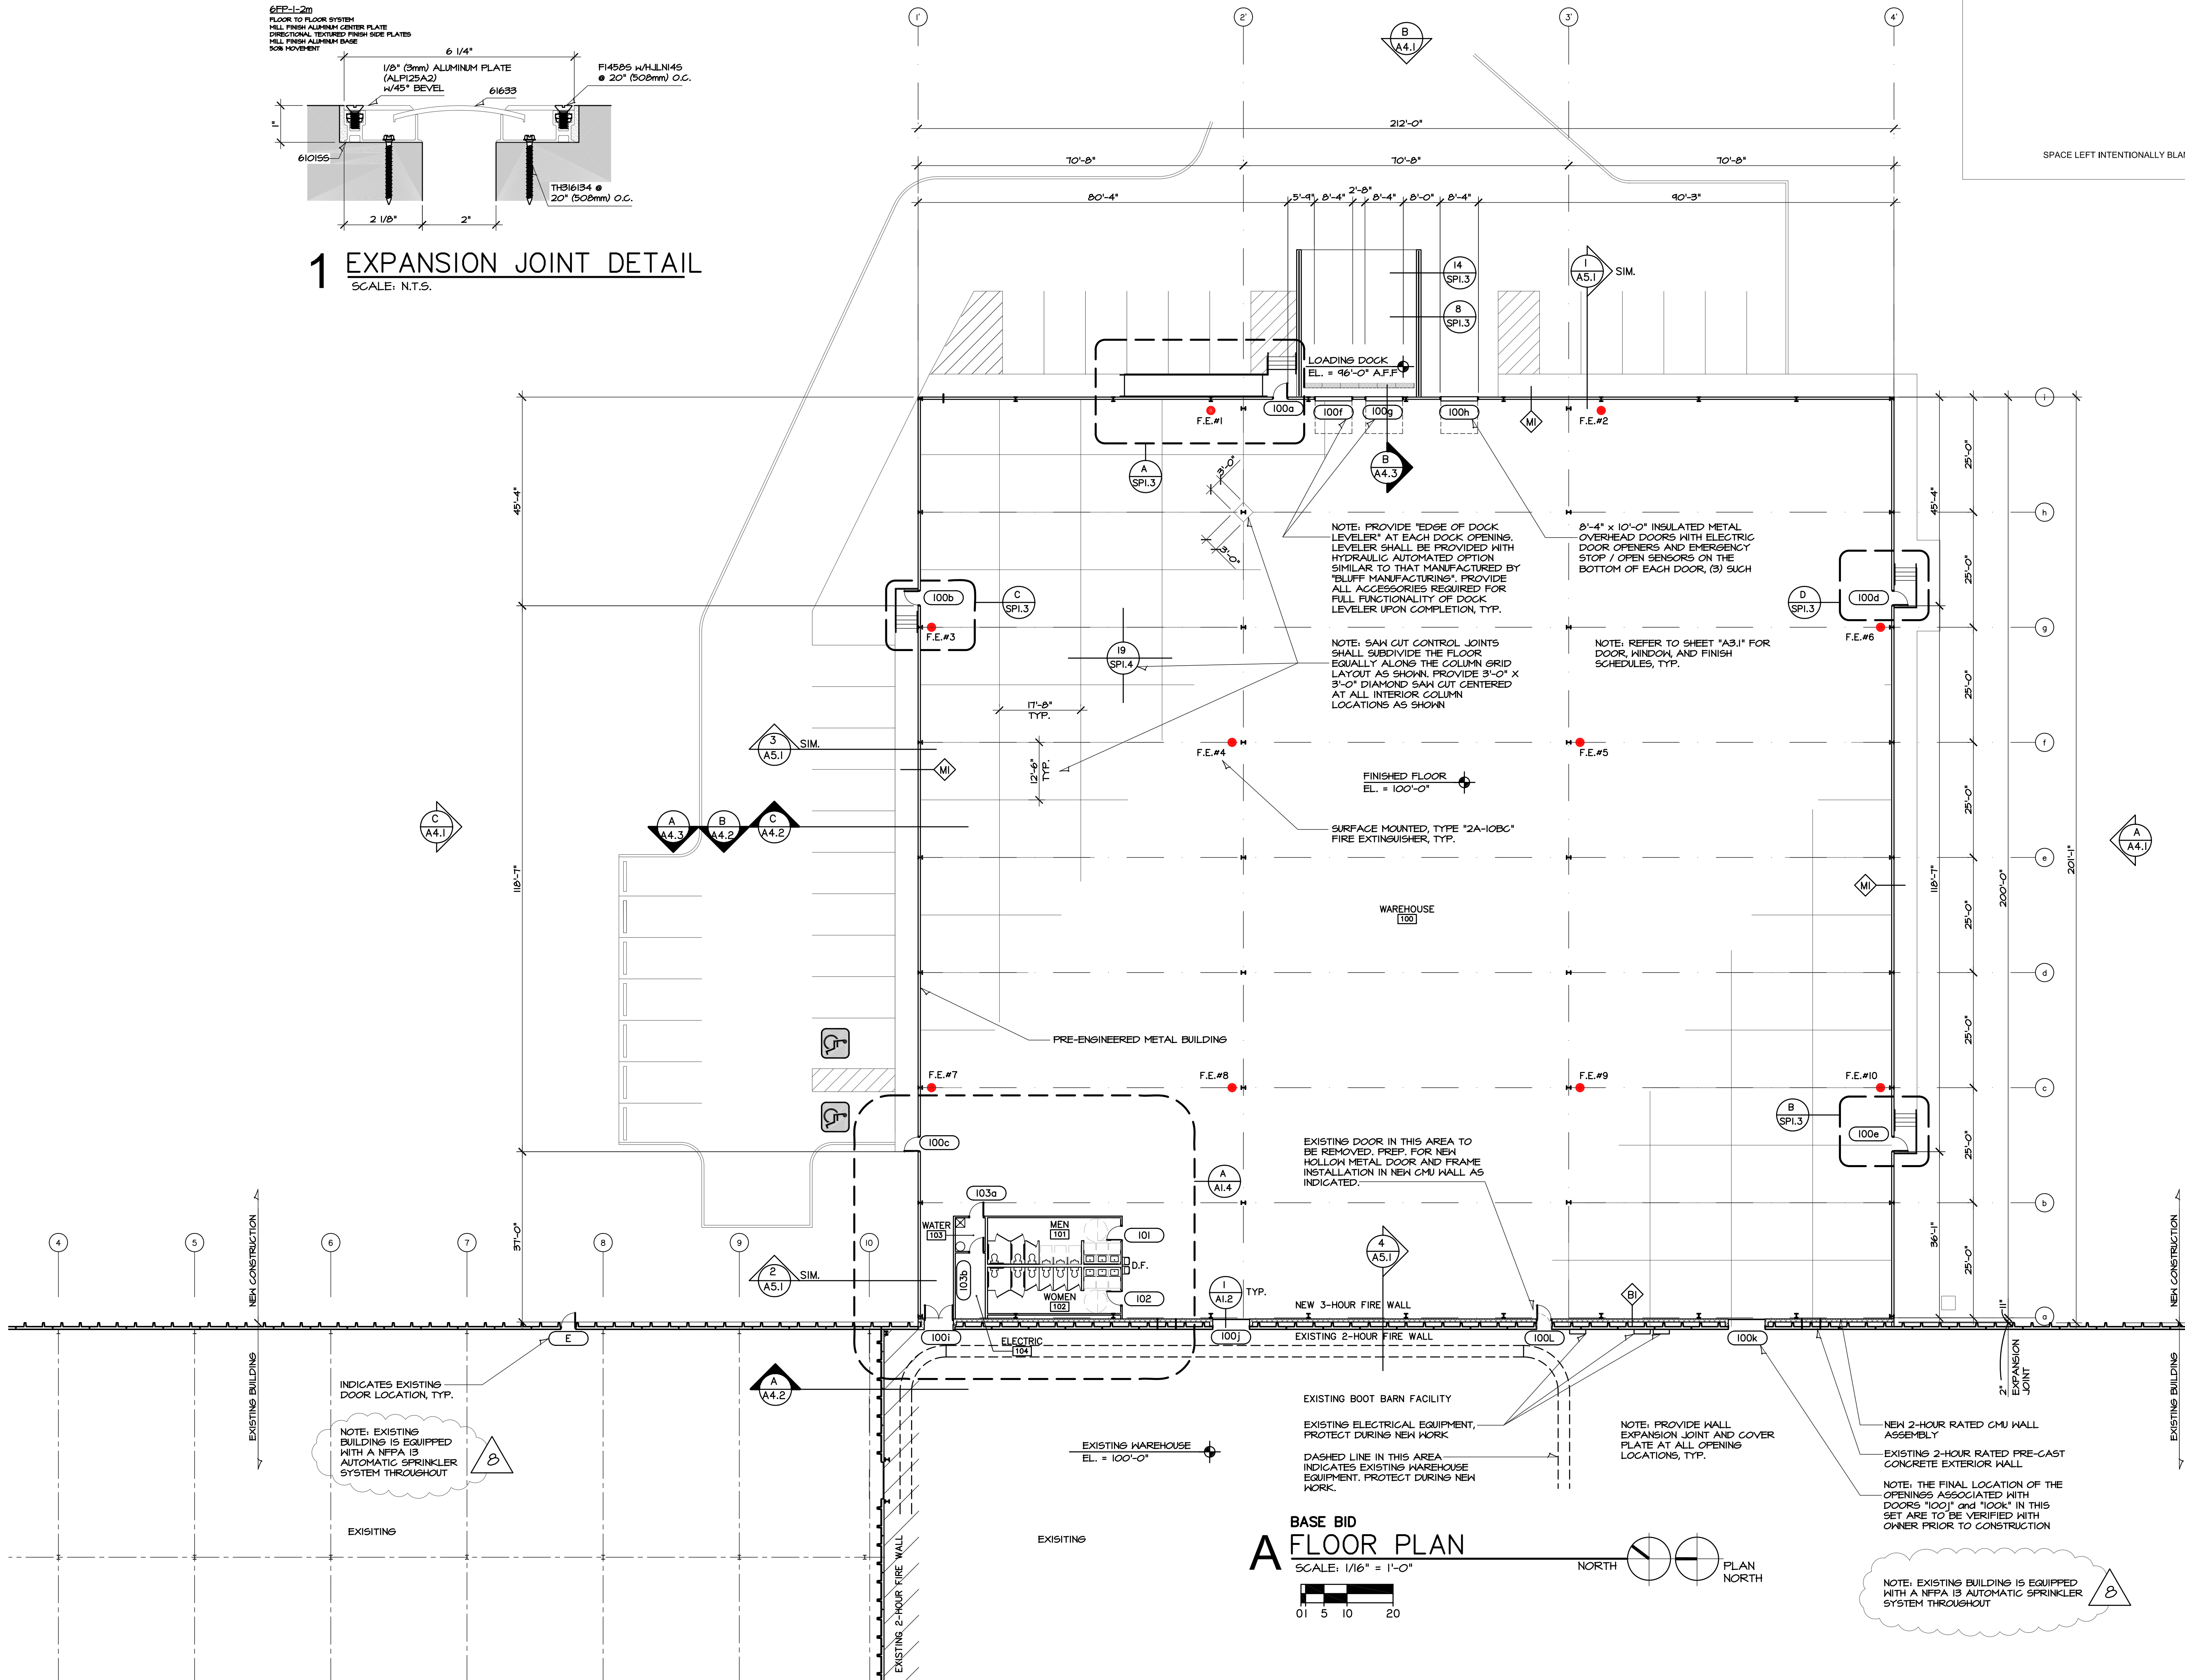

HANNEY & ASSOCIATES, ARCHITECTS  
1726 South Hillside, Wichita, Kansas, 67211  
Phone (316) 883-8965  
Fax (316) 884-1441  
www.hanarchitects.com

**2019  
BOOT BARN  
WAREHOUSE EXPANSION**  
4950 South Laura, Wichita, Kansas 67216

DRAWINGS ISSUED		
NO.	DATE	ITEM ISSUED
7	7/15	PLAN REVIEW REV. 1
6	6/25	PLAN REVIEW
5	6/14	100% REVIEW
4	6/05	PLAN CHANGE
3	5/28	PLAN CHANGE
2	4/26	REVIEW
1	1/24	REVIEW

COMPUTER DRAWING  
BB\_A102.dwg

DATE: JUNE, 2019  
DRAWN BY: MH, BS, CH  
CHECKED BY: MRH

SHEET  
**A1.2**  
OF 1 SHEETS