


1 EXPANSION JOINT DETAIL
SCALE: N.T.S.



**BASE BID
A FLOOR PLAN**
SCALE: 1/16" = 1'-0"
01 5 10 20
NORTH PLAN NORTH

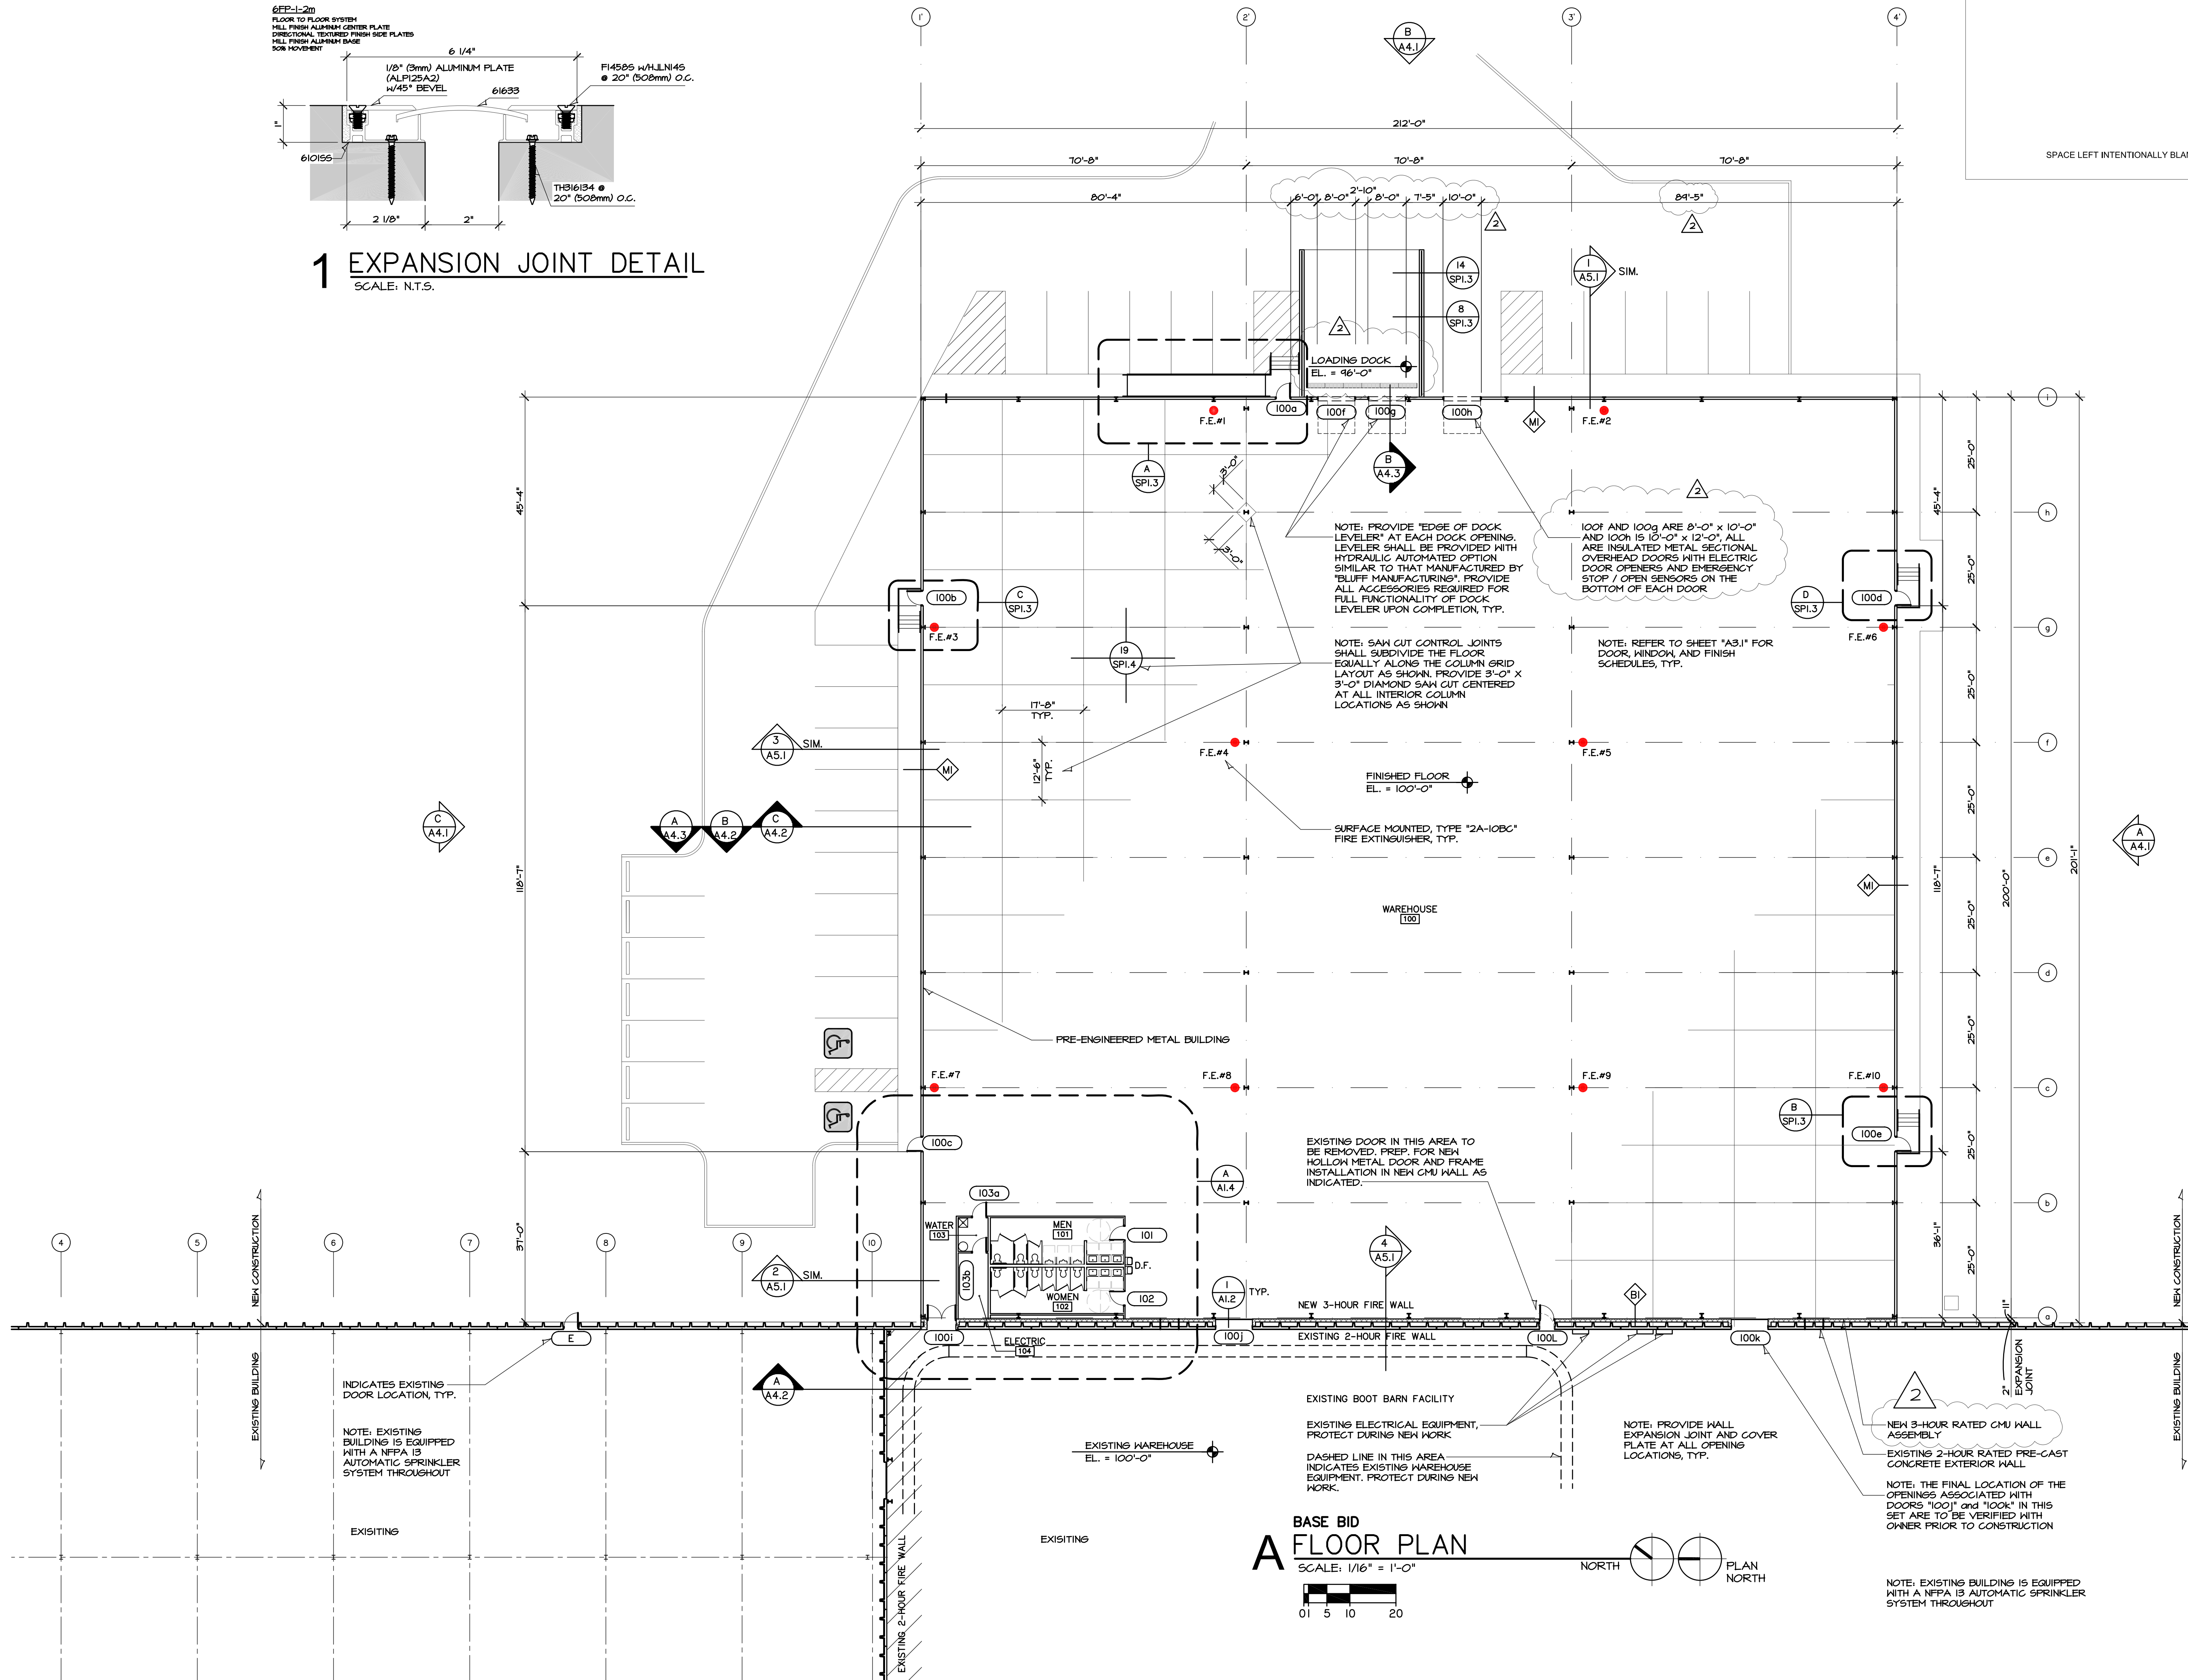

HANNEY & ASSOCIATES, ARCHITECTS
1726 South Hillside, Wichita, Kansas, 67211
Phone (316) 883-8965
Fax (316) 884-1441
www.hanneyarchitects.com

**2019
BOOT BARN
WAREHOUSE EXPANSION**
4950 South Laura, Wichita, Kansas 67216

DRAWINGS ISSUED		
NO.	DATE	ITEM ISSUED
1	1/24	REVIEW
2	4/26	REVIEW
3	5/28	PLAN CHANGE
4	6/05	PLAN CHANGE
5	6/14	100% REVIEW
6	6/25	PLAN REVIEW
7	7/15	PLAN REVIEW REV. 1
9	8/22	ADDENDUM #2

COMPUTER DRAWING
BB_A102.dwg

DATE: JUNE, 2019
DRAWN BY: MH, BS, CH
CHECKED BY: MRH

SHEET
A1.2
OF 1 SHEETS