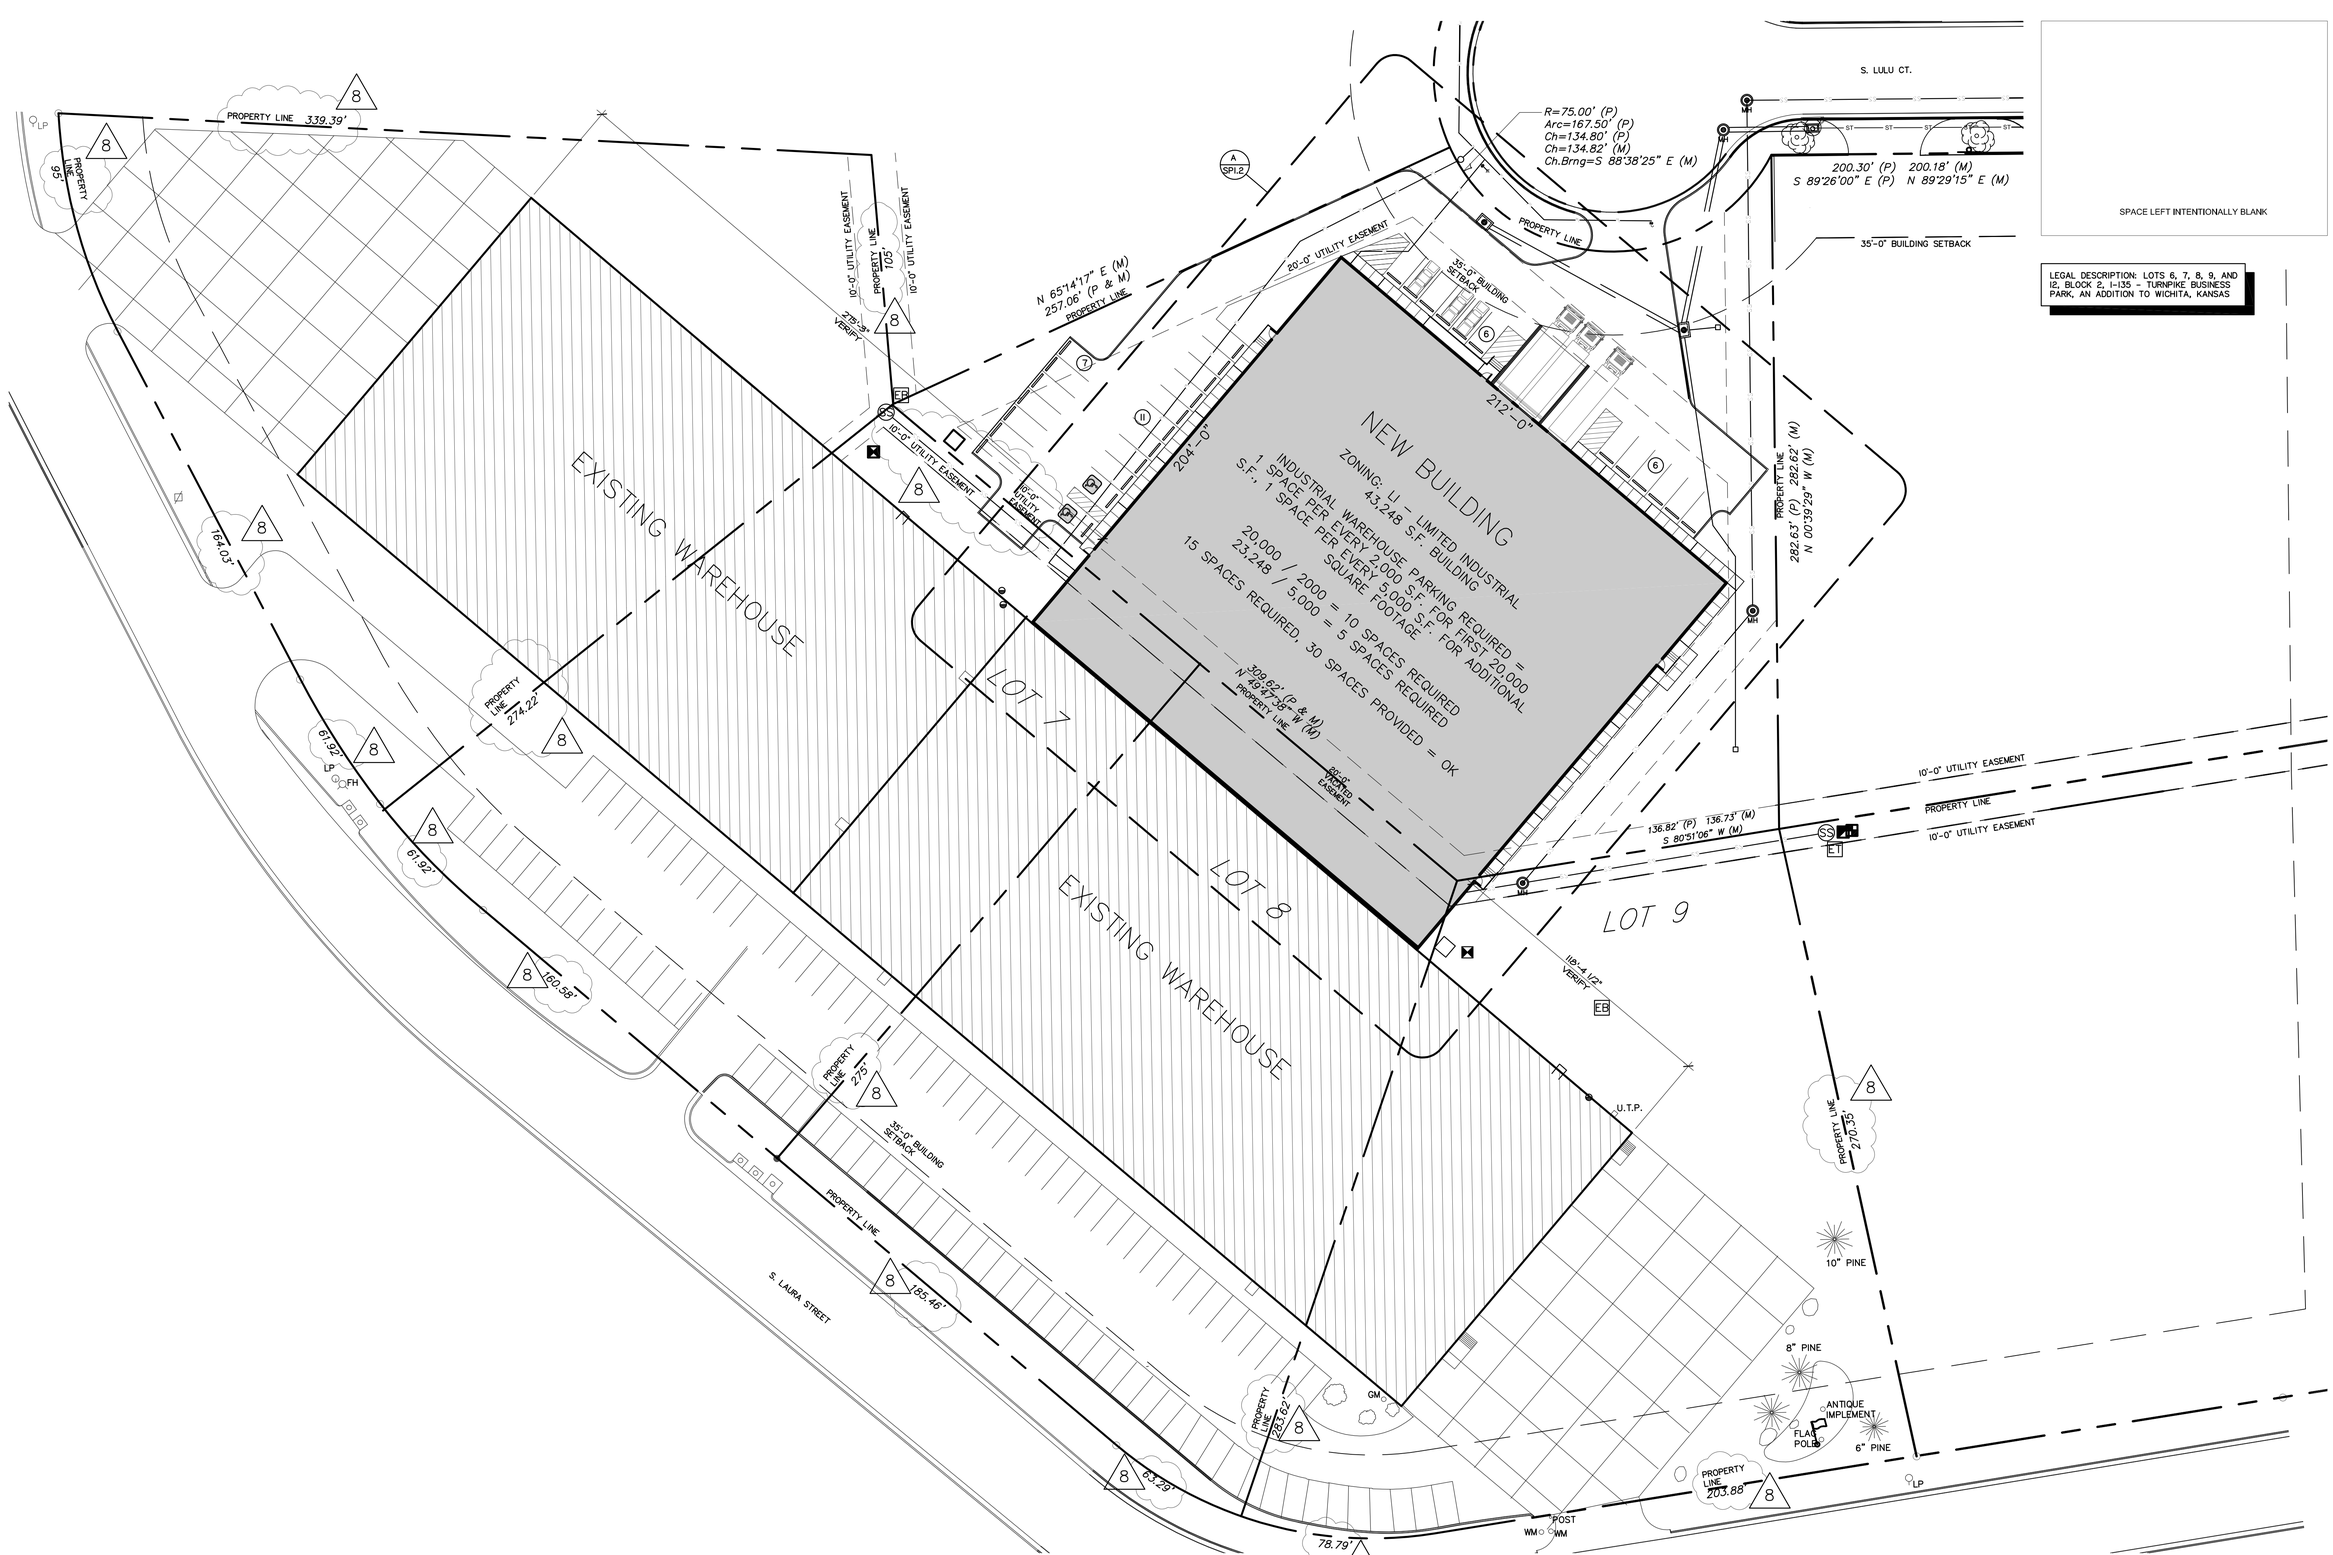

A OVERALL SITE PLAN
SCALE: 1" = 30'-0"

NORTH

0 5 10 20 50

ARCHITECTS

JORDON R. HANNEY
LICENSED
37005
KANSAS
PROFESSIONAL ARCHITECT

7/16/19

HANNEY & ASSOCIATES, ARCHITECTS
1726 South Hillside, Wichita, Kansas, 67211
Phone (316) 683-8965
Fax (316) 684-1441
www.haarchitects.com

2019 BOOT BARN WAREHOUSE EXPANSION

4950 South Laura, Wichita, Kansas 67216

DRAWINGS ISSUED		
NO.	DATE	ITEM ISSUED
8	8/13	PLAN REVIEW REV. 2
7	7/15	PLAN REVIEW REV. 1
6	6/25	PLAN REVIEW
5	6/14	100% REVIEW
4	6/05	PLAN CHANGE
3	5/28	PLAN CHANGE
2	4/26	REVIEW
1	1/24	REVIEW

COMPUTER DRAWING
BB_SP101.dwg

DATE: JUNE, 2019	
DRAWN BY:	CHECKED BY:
MH, BS, CH	MRH

SHEET

SP1.1

OF 1 SHEETS